


East

<-North

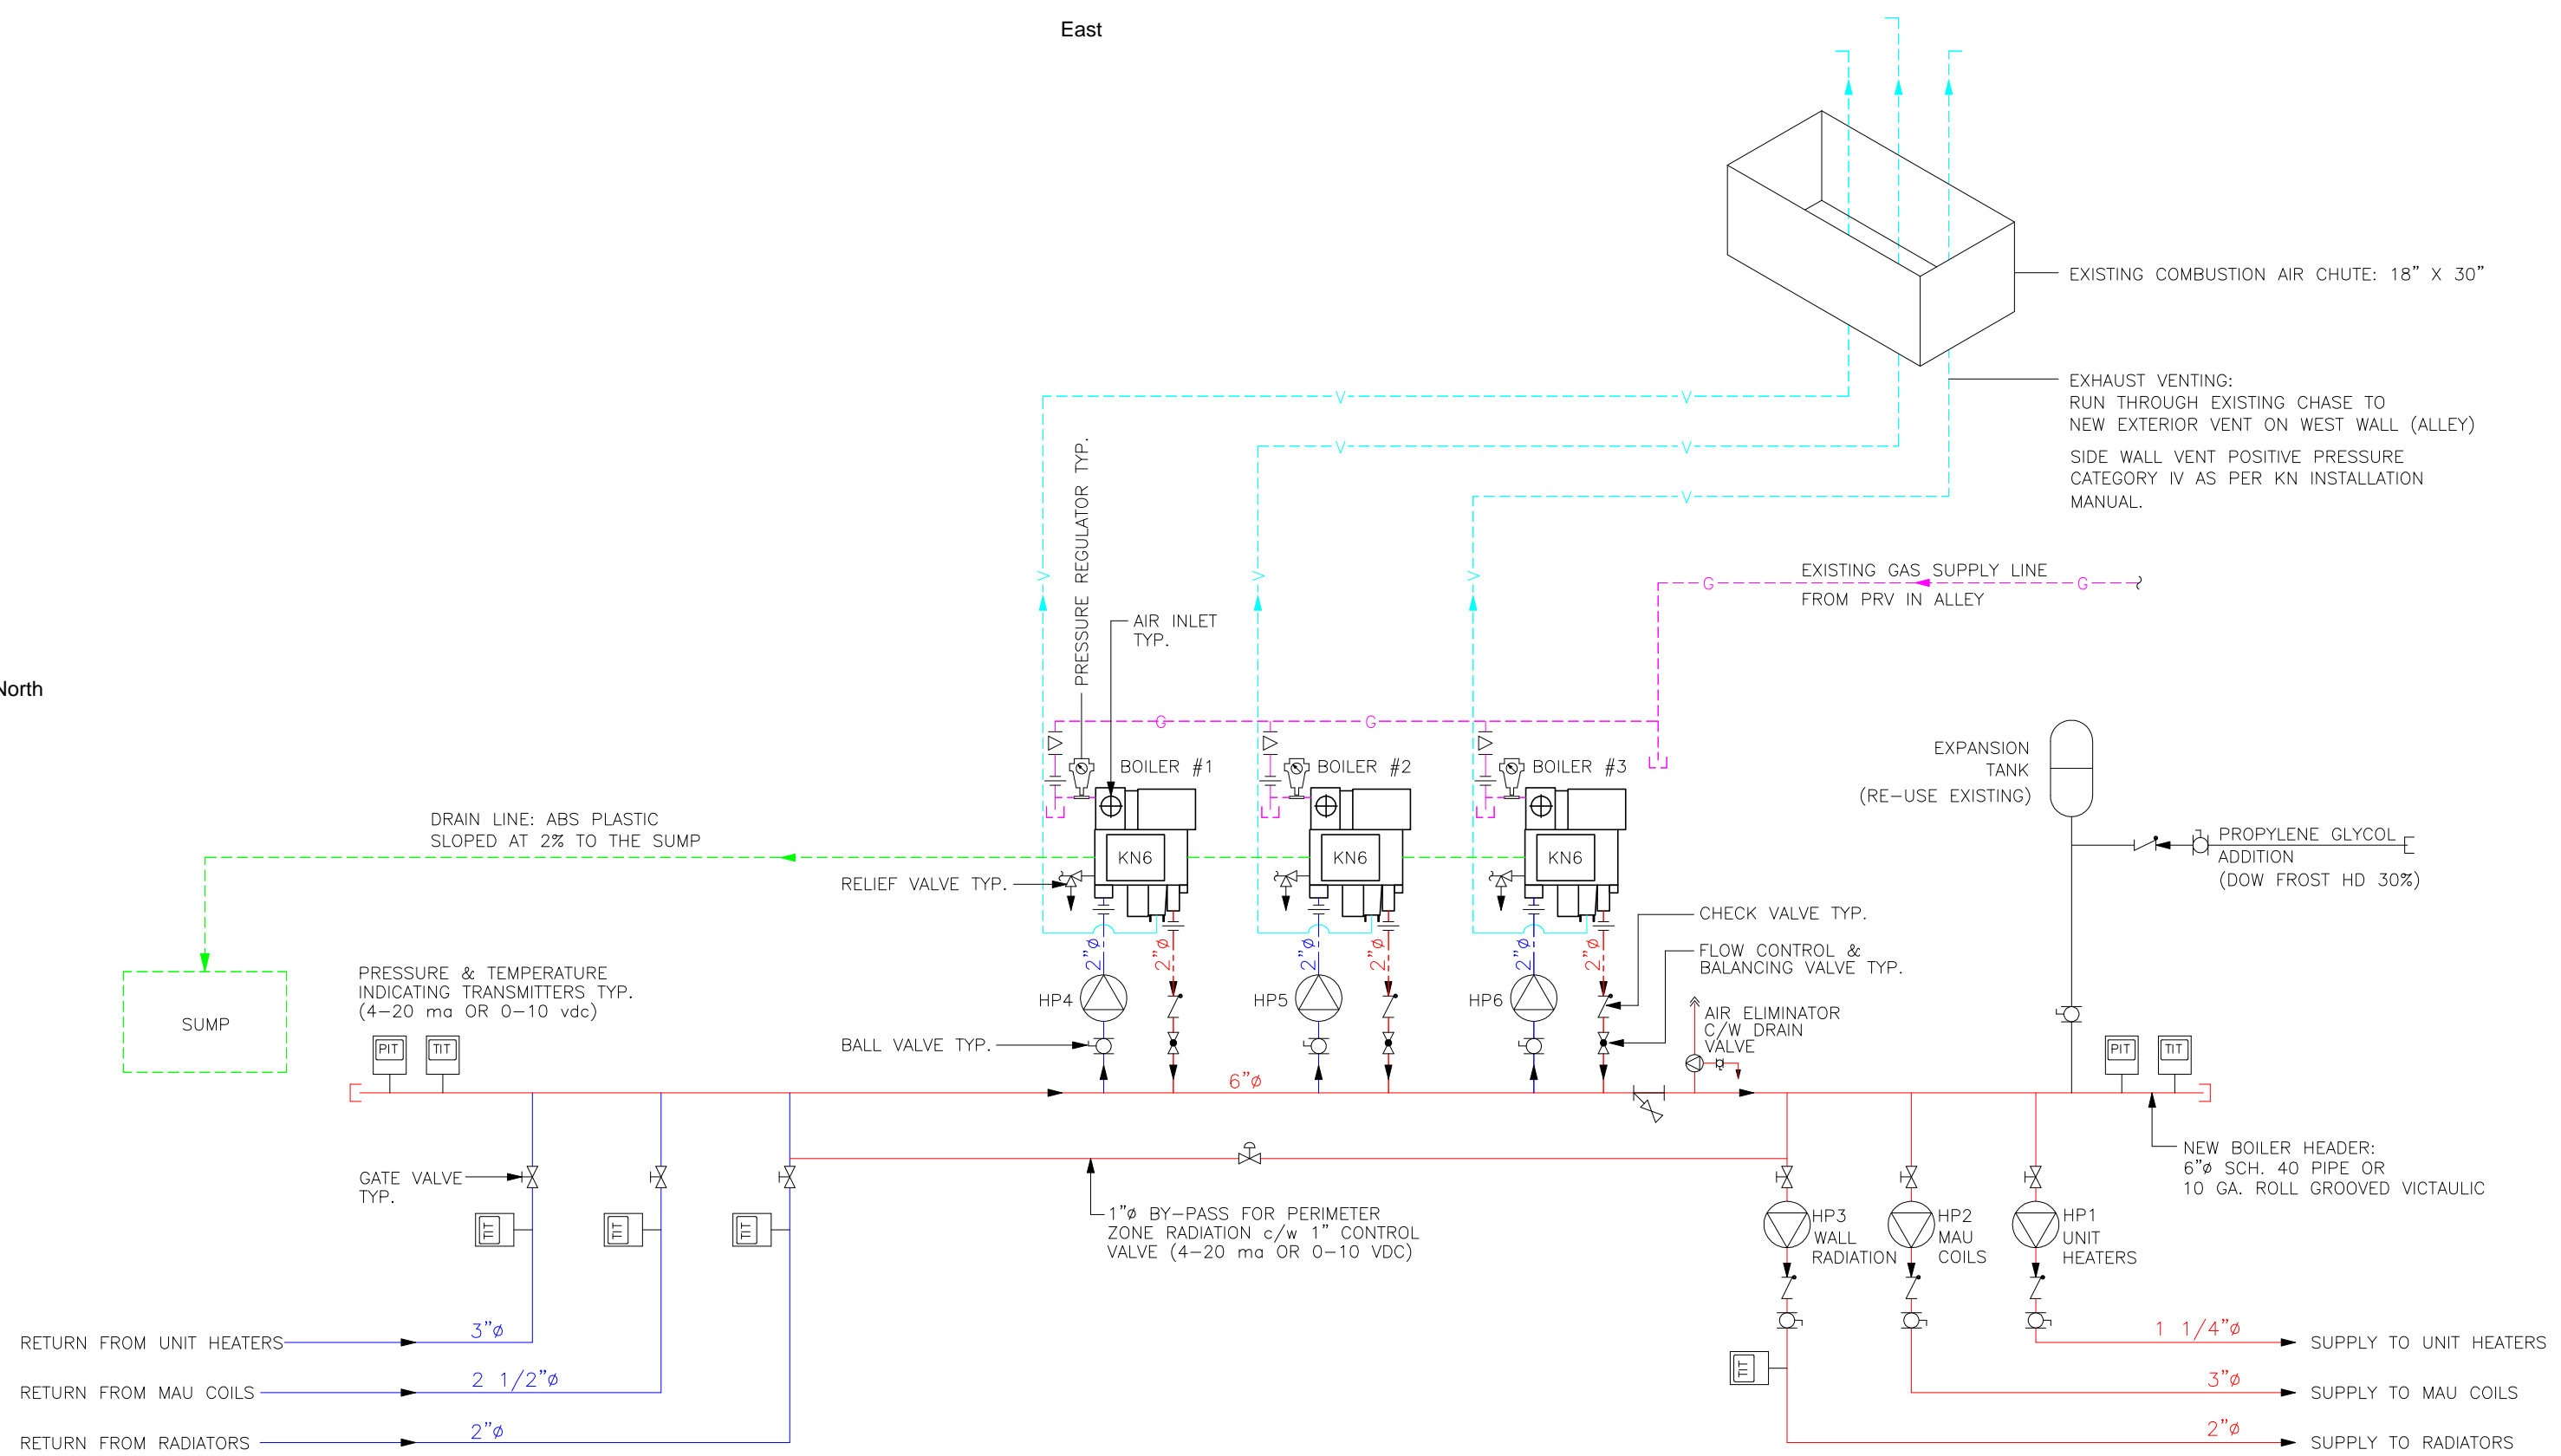

AS BUILT  
DATE: \_\_\_\_\_

**REW**  
R E WEDDING CONSULTANTS  
CONSULTING ENGINEERS  
COQUITLAM BC 1-604-505-5940  
rewassociates.com

Note: North and East added later by DK

REV.	DATE	DESCRIPTION

Do not scale off this dwg., if not plotted on original paper size.  
Copyright Reserved. Use or reproduction in whole or in part is prohibited without express permission from REW Consultants

Mount Pleasant War Memorial  
Cooperative Association  
Vancouver, BC

New Boilers & Piping Schematic  
Planet Bingo

DRAWN: DAP	CHK'D:	DATE: SEPT 2010	Dwg. No.
DES'D: REW	APP.:	JOB: 504-09	M-5A